

AMENDMENT	DATE	DESCRIPTION
R1	16.7.12	SEWER PRESSURE MAIN ASBUILT ADDED.
R2	17.7.12	LATERALS FOR 3,4,5,6,7,22,35,43 & 46 EXTENDED.
R3	27.7.12	PUMPSTATION DETAIL & COORDINATES ADDED.

NOTES:

- 1) ALL LATERAL AND SEWER PRESSURE MAINS BUILT INFORMATION WAS PROVIDED BY FULTON HOGAN LIMITED AND NO LIABILITY IS ACCEPTED FOR THE ACCURACY OF THIS INFORMATION.
- 2) THIS PLAN HAS BEEN PREPARED FOR ASBUILT PURPOSES ONLY. NO LIABILITY IS ACCEPTED IF THE PLAN IS USED FOR ANY OTHER PURPOSE.
- 3) ANY MEASUREMENTS TAKEN FROM INFORMATION WHICH IS NOT DIMENSIONED ON THE ELECTRONIC COPY ARE AT THE RISK OF THE RECIPIENT.
- 4) ORIGIN OF LEVELS
BM.EHC6 RL=28.99
CORNER OF AWATEA & WIGRAM ROADS
LEVELS IN TERMS OF CHRISTCHURCH DRAINAGE DATUM.
JANUARY 2012 ISSUE



DAVIE LOVELL • SMITH
PLANNING SURVEYING ENGINEERING

79 Cambridge Terrace P O Box 679 Christchurch 8140. New Zealand
Telephone: 03 379-0793 Fax: 03 379-5664 E-mail: office@dis.co.nz

JOB TITLE:
Fulton Hogan Land Development Ltd
Longhurst Stages 1 & 1A

SHEET TITLE:
Sewer - Asbuilt
RMA 92015254


DRAWING STATUS:
Asbuilt

SCALE: 1:500@A1 DATE: July 2012
1:1000@A3

CAD FILE: J:\16011\Eng\Longhurst\Asbuilt\S16011.AB01 STG1 R3.dwg REVISION:
DRAWING No: S.16011 SHEET No: ABSS01 R.3


SERVICES

MH	
SANITARY SEWER	
SANITARY SEWER PRESSURE MAIN	
EX SEWER MAIN	
KERB	

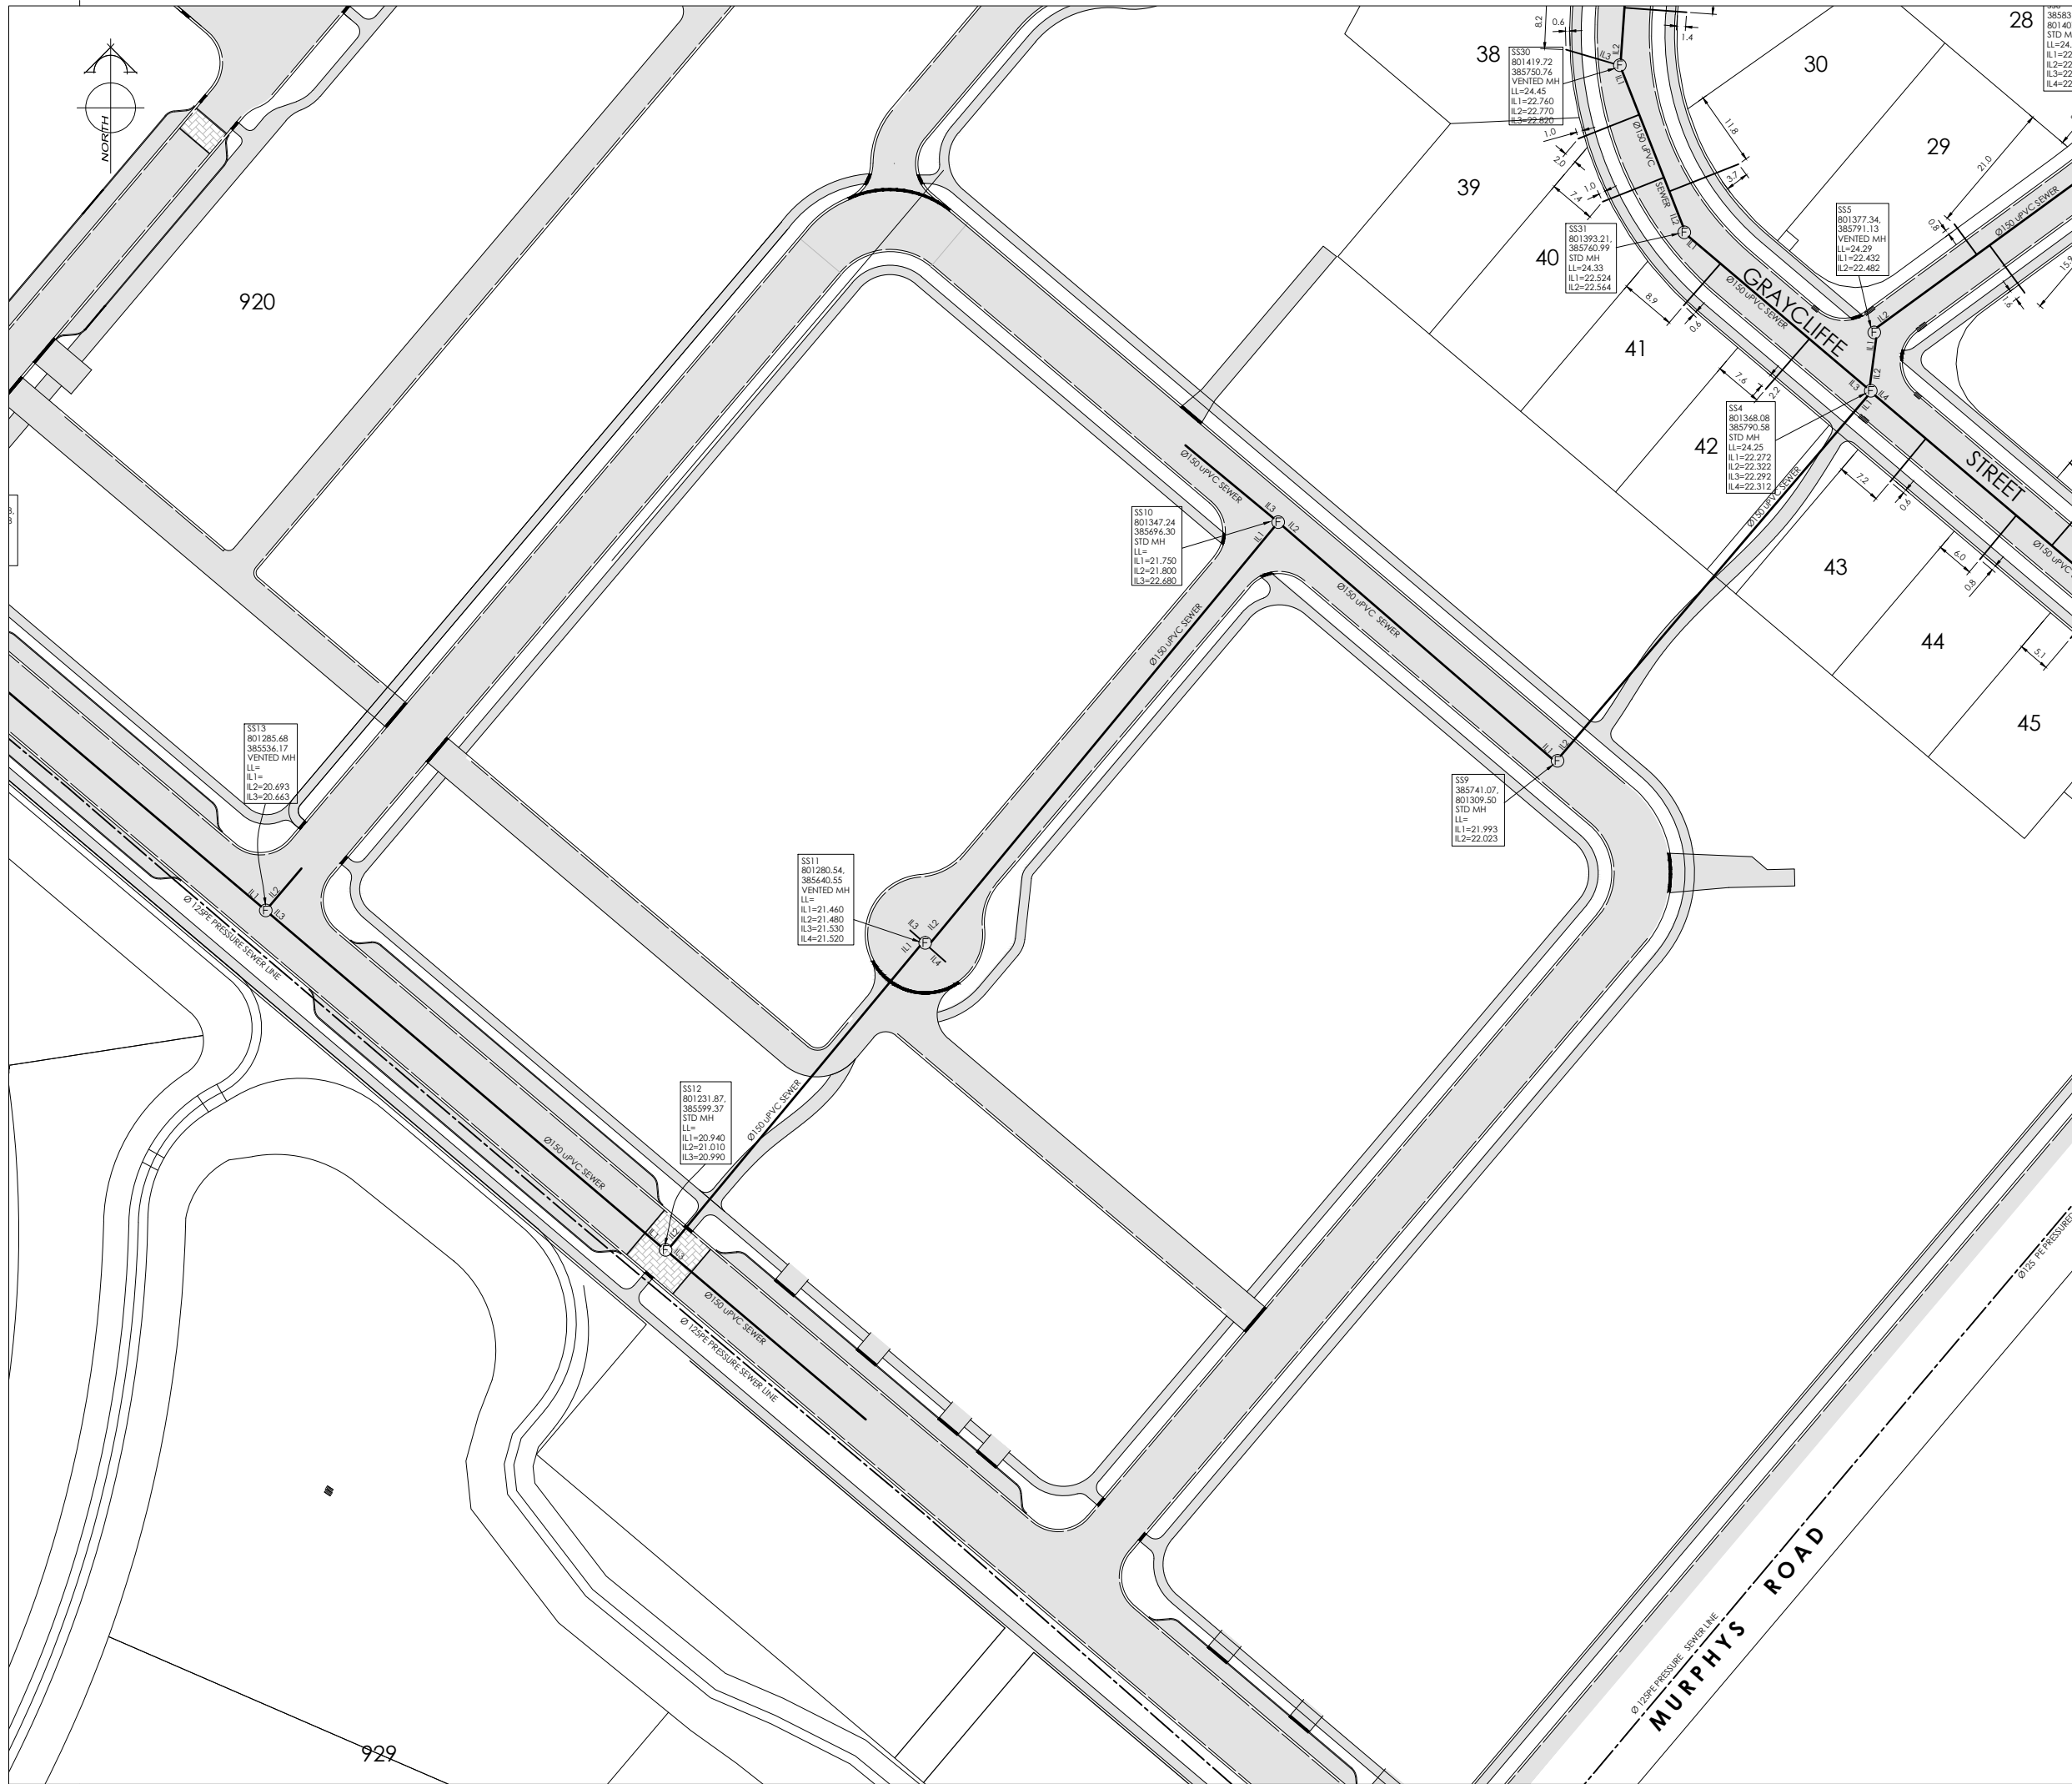

AMENDMENT	DATE	DESCRIPTION
R1	16.7.12	SEWER PRESSURE MAIN ASBUILT ADDED.
R2	17.7.12	LATERALS FOR 3,4,5,6,7,22,35,43 & 46 EXTENDED.
R3	27.7.12	PUMPSTATION DETAIL & COORDINATES ADDED.

- NOTES:**
- 1) ALL LATERAL AND SEWER PRESSURE MAINS ASBUILT INFORMATION WAS PROVIDED BY FULTON HOGAN LIMITED AND NO LIABILITY IS ACCEPTED FOR THE ACCURACY OF THIS INFORMATION.
 - 2) THIS PLAN HAS BEEN PREPARED FOR ASBUILT PURPOSES ONLY. NO LIABILITY IS ACCEPTED IF THE PLAN IS USED FOR ANY OTHER PURPOSE.
 - 3) ANY MEASUREMENTS TAKEN FROM INFORMATION WHICH IS NOT DIMENSIONED ON THE ELECTRONIC COPY ARE AT THE RISK OF THE RECIPIENT.
 - 4) **ORIGIN OF LEVELS**
 BM.EHC6 RL=28.99
 CORNER OF AWATEA & WIGRAM ROADS
 LEVELS IN TERMS OF CHRISTCHURCH DRAINAGE DATUM.
 JANUARY 2012 ISSUE

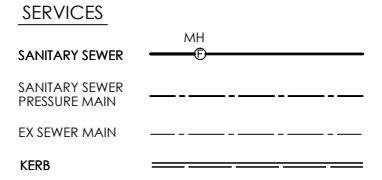

DESIGNED BY	NAME	SIGNED	DATE
CHECKED BY	MATTHEW WENBORN		
	ANDY HALL		

DAVIE LOVELL • SMITH
 PLANNING SURVEYING ENGINEERING

79 Cambridge Terrace P O Box 679 Christchurch 8140. New Zealand
 Telephone: 03 379-0793 Fax: 03 379-5664 E-mail: office@dls.co.nz


JOB TITLE:
 Fulton Hogan Land Development Ltd
 Longhurst Stages 1 & 1A

SHEET TITLE:
 Sewer - Asbuilt
 RMA 92015254

DRAWING STATUS:
 Asbuilt

SCALE: 1:500@A1 DATE: July 2012
 1:1000@A3

CAD FILE: J:\16011\Eng\Longhurst\Asbuilt\S16011.AB01 STG1 R3.dwg REVISION:
 DRAWING No: SHEET No:
S.16011 ABSS02 R.3

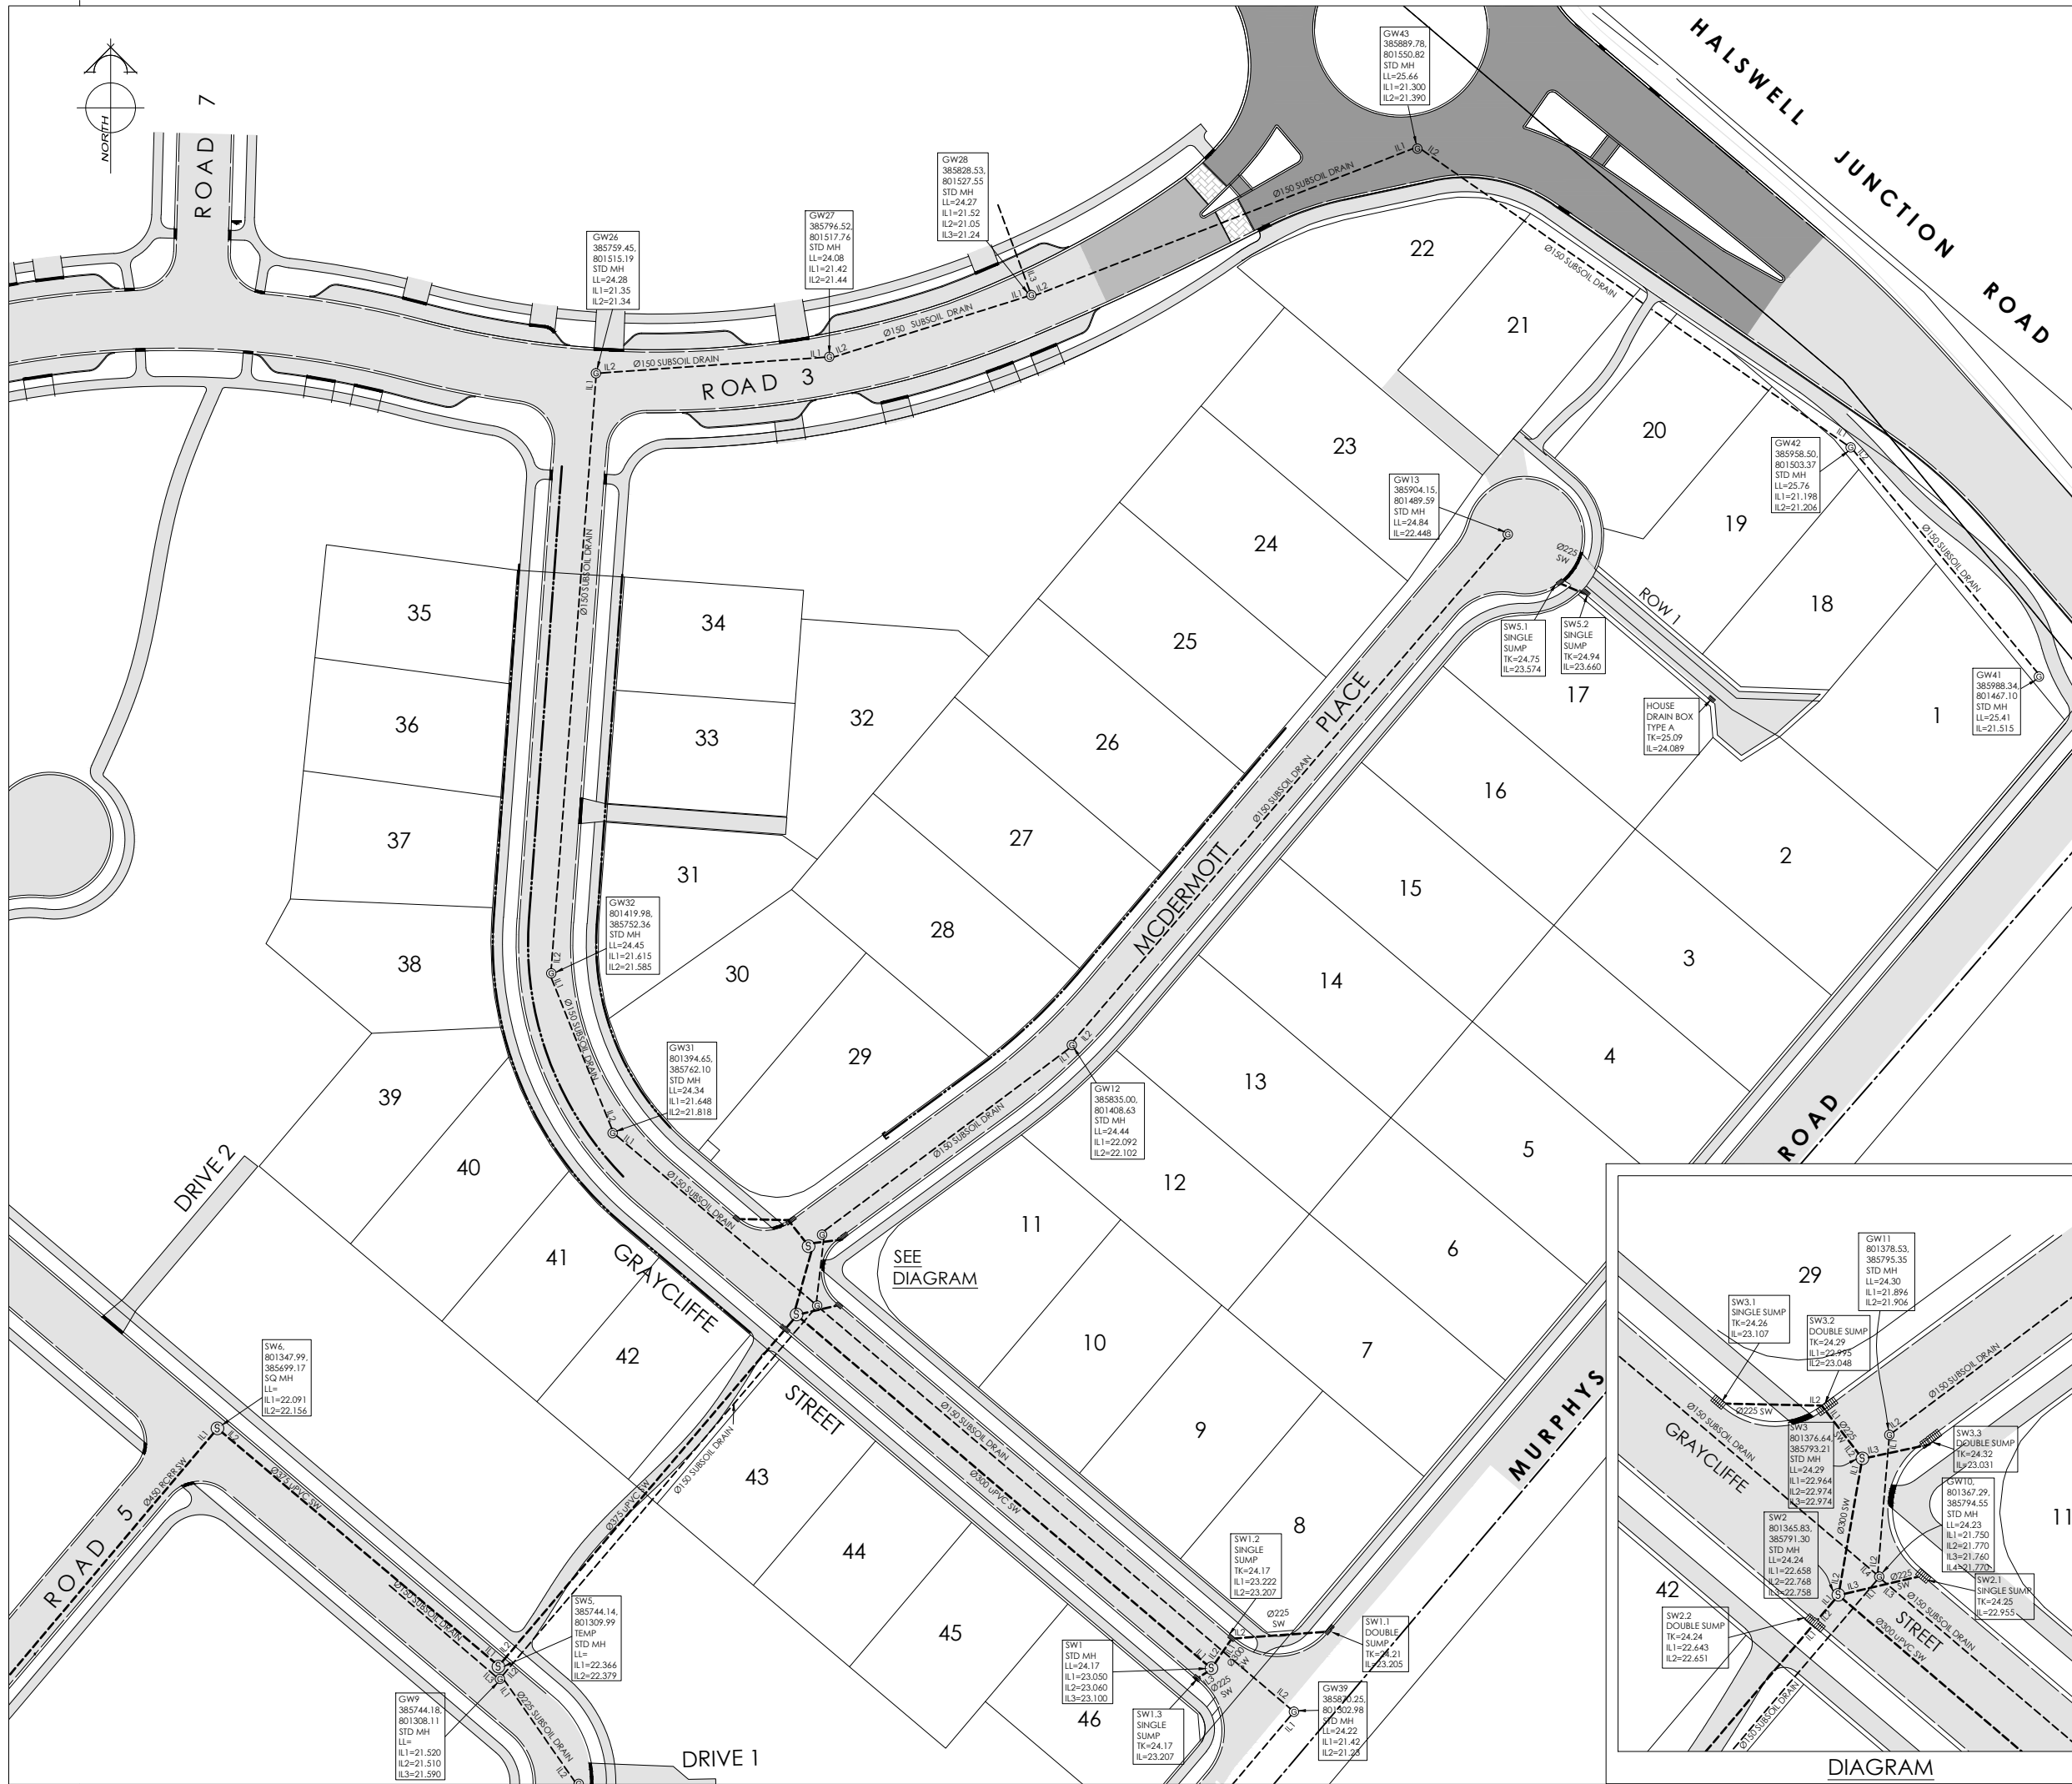


AMENDMENTS:		
AMENDMENT	DATE	DESCRIPTION
R1	16.7.12	SEWER PRESSUREMAIN ASBUILT ADDED.
R2	17.7.12	LATERALS FOR 3,4,5,6,7,22,35,43 & 46 EXTENDED.
R3	27.7.12	PUMPSTATION DETAIL & COORDINATES ADDED.

NOTES:

- 1) THIS PLAN HAS BEEN PREPARED FOR ASBUILT PURPOSES ONLY. NO LIABILITY IS ACCEPTED IF THE PLAN IS USED FOR ANY OTHER PURPOSE.
- 2) ANY MEASUREMENTS TAKEN FROM INFORMATION WHICH IS NOT DIMENSIONED ON THE ELECTRONIC COPY ARE AT THE RISK OF THE RECIPIENT.
- 3) ORIGIN OF LEVELS
 BM.EHC6 RL=28.99
 CORNER OF AWATEA & WIGRAM ROADS

LEVELS IN TERMS OF CHRISTCHURCH DRAINAGE DATUM, JANUARY 2012 ISSUE

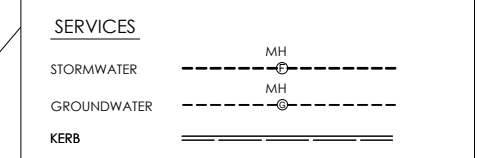

	NAME	SIGNED	DATE
DESIGNED BY	MATTHEW WENBORN		
CHECKED BY	ANDY HALL		

DAVIE LOVELL • SMITH
 PLANNING SURVEYING ENGINEERING

79 Cambridge Terrace P O Box 679 Christchurch 8140. New Zealand
 Telephone: 03 379-0793 Fax: 03 379-5664 E-mail: office@dls.co.nz


JOB TITLE:
Fulton Hogan Land Development Ltd
Longhurst Stages 1 & 1A

SHEET TITLE:
Stormwater - Asbuilt
RMA 92015254

DRAWING STATUS:
Asbuilt

SCALE: 1:500@A1 DATE: July 2012
 1:1000@A3

CAD FILE: J:\16011\Eng\Longhurst\Asbuilt\S16011.AB01 STG1 R3.dwg REVISION:
 DRAWING No: **S.16011 ABSW01** SHEET No: **R.3**

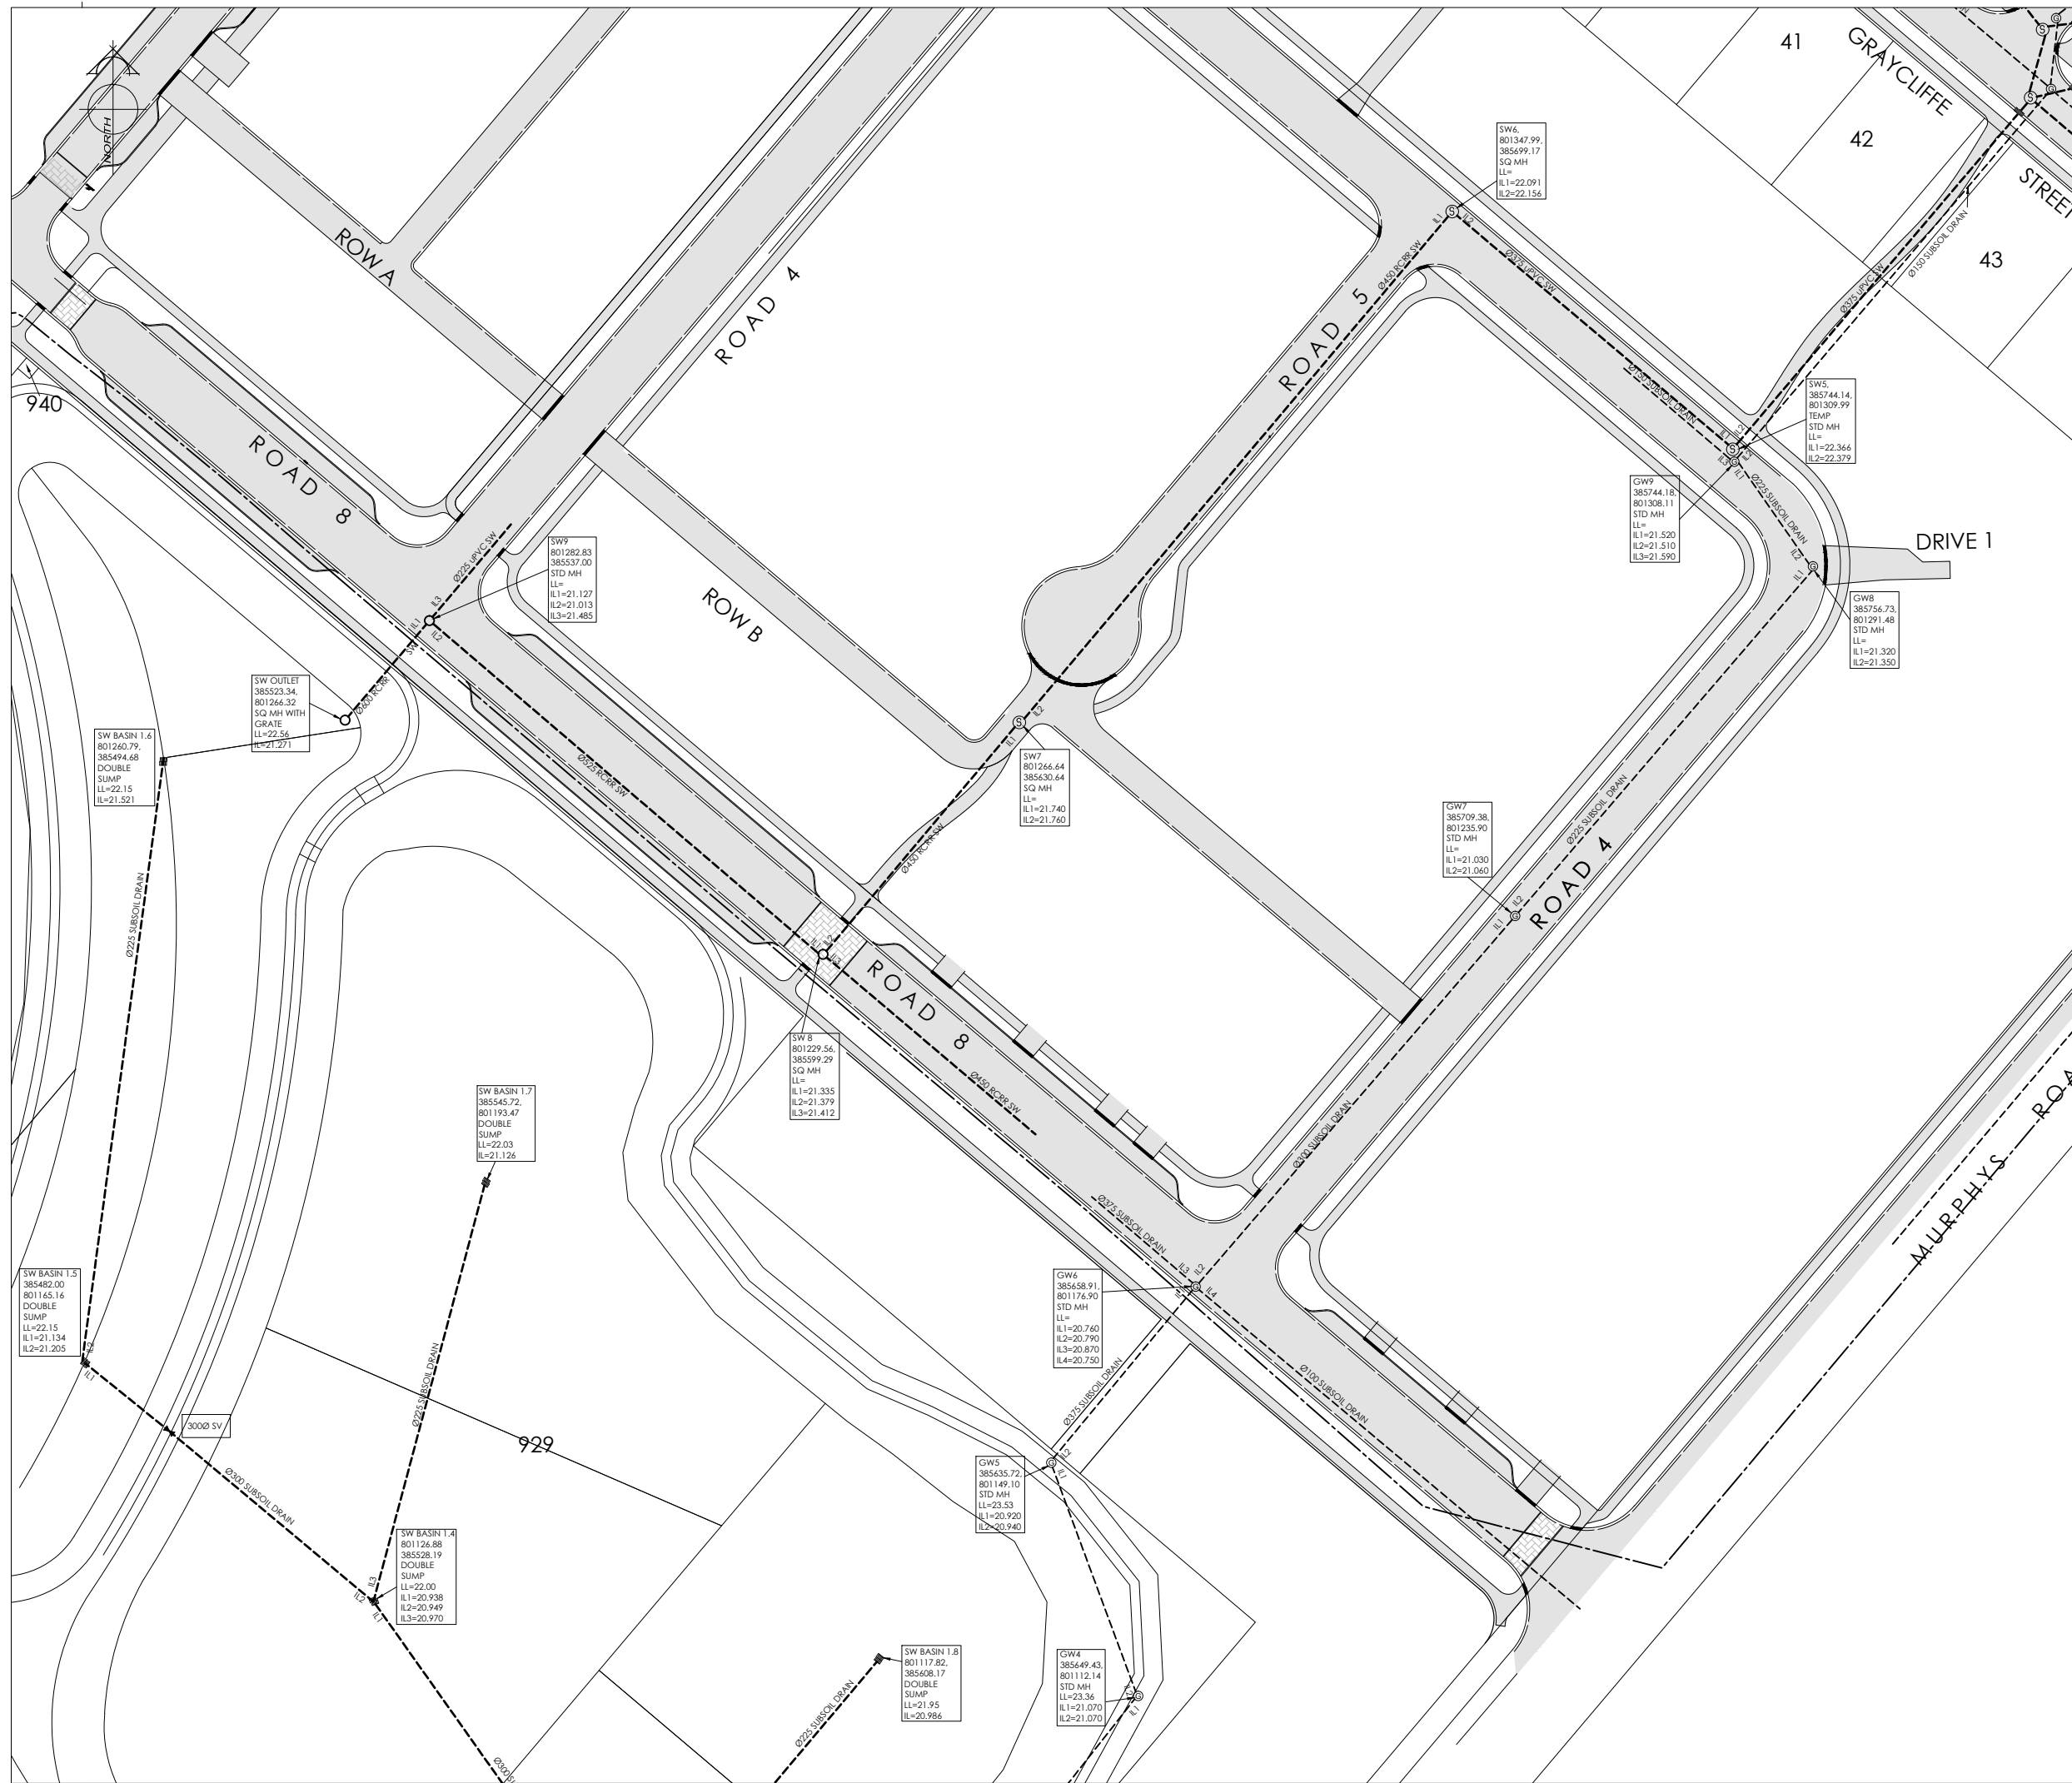


AMENDMENTS:		
AMENDMENT	DATE	DESCRIPTION
R1	16.7.12	SEWER PRESSUREMAIN ASBUILT ADDED.
R2	17.7.12	LATERALS FOR 3,4,5,6,7,22,35,43 & 46 EXTENDED.
R3	27.7.12	PUMPSTATION DETAIL & COORDINATES ADDED.

NOTES:

- THIS PLAN HAS BEEN PREPARED FOR ASBUILT PURPOSES ONLY. NO LIABILITY IS ACCEPTED IF THE PLAN IS USED FOR ANY OTHER PURPOSE.
- ANY MEASUREMENTS TAKEN FROM INFORMATION WHICH IS NOT DIMENSIONED ON THE ELECTRONIC COPY ARE AT THE RISK OF THE RECIPIENT.
- ORIGIN OF LEVELS
BM.EHC6 RL=28.99
CORNER OF AWATEA & WIGRAM ROADS

LEVELS IN TERMS OF CHRISTCHURCH DRAINAGE DATUM.
JANUARY 2012 ISSUE

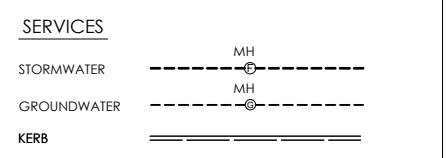

NAME	SIGNED	DATE
DESIGNED BY MATTHEW WENBORN		
CHECKED BY ANDY HALL		



79 Cambridge Terrace P O Box 679 Christchurch 8140. New Zealand
Telephone: 03 379-0793 Fax: 03 379-5664 E-mail: office@dls.co.nz



JOB TITLE:
Fulton Hogan Land Development Ltd
Longhurst Stages 1 & 1A

SHEET TITLE:
Stormwater - Asbuilt
RMA 92015254

DRAWING STATUS:
Asbuilt

SCALE: 1:500@A1 DATE: July 2012
1:1000@A3

CAD FILE: J:\16011\Eng\Longhurst\Asbuilt\S16011.AB01 STG1 R3.dwg REVISION:
DRAWING No: S.16011 SHEET No: ABSW02 R.3

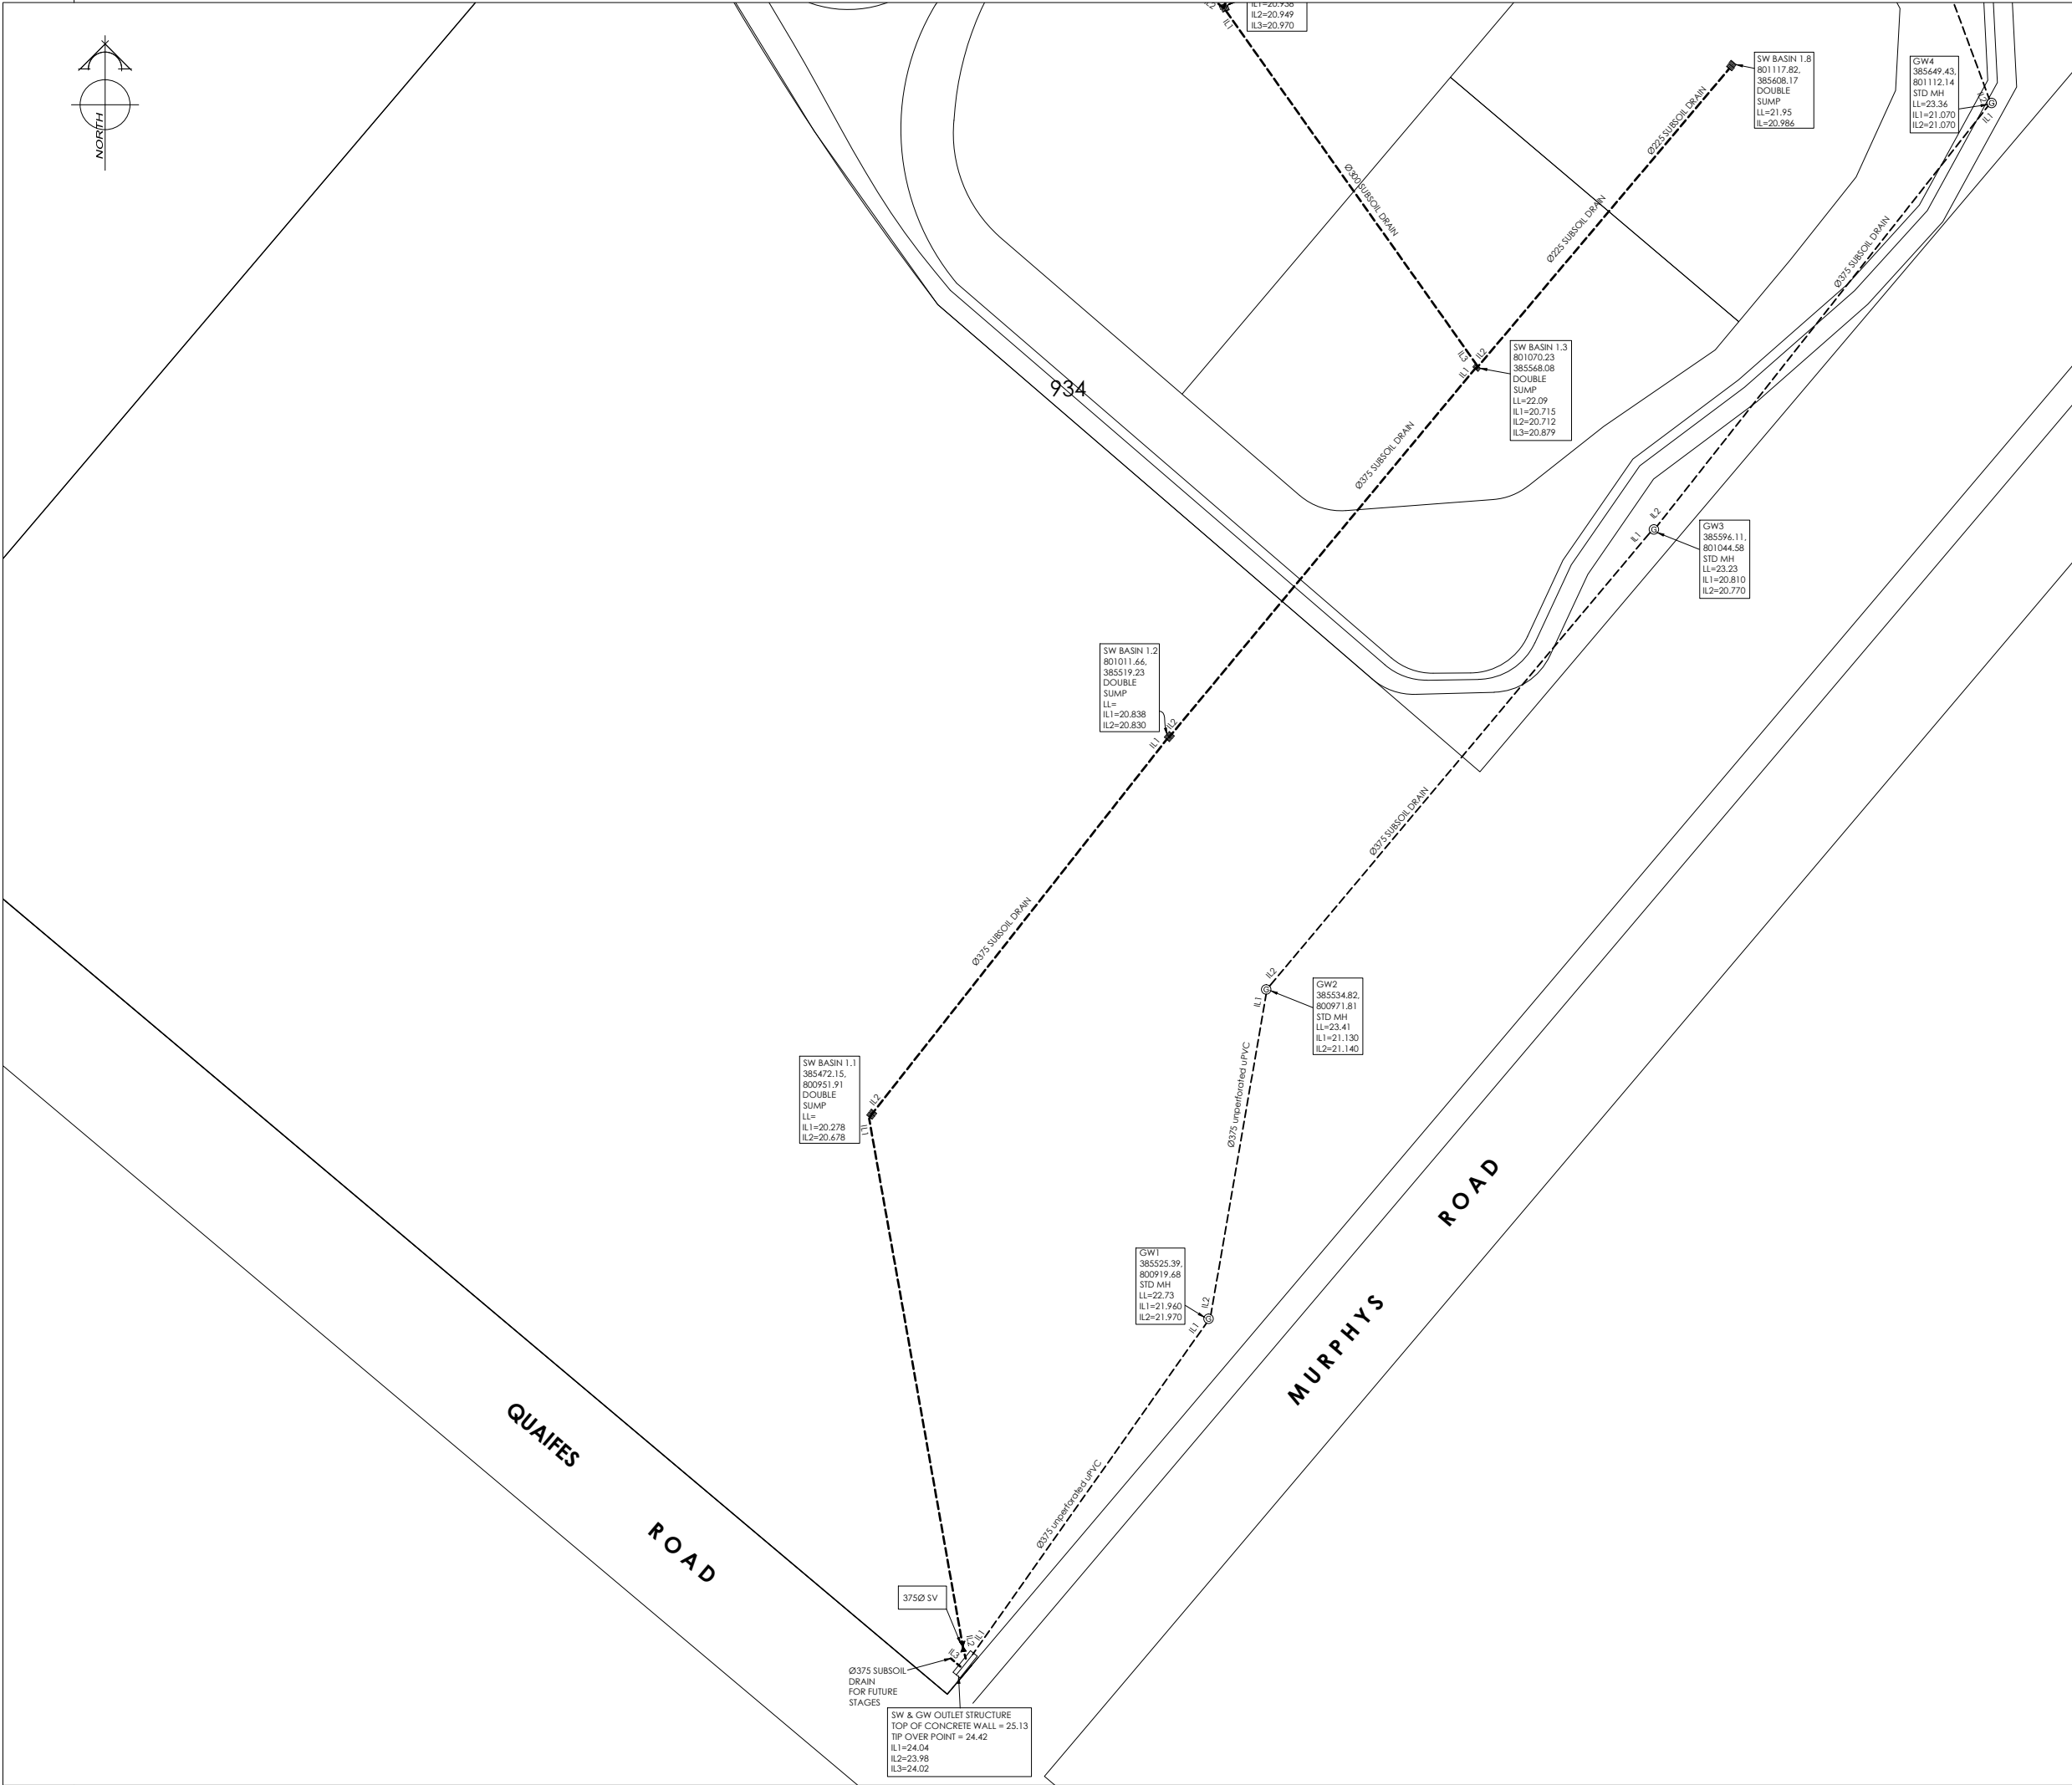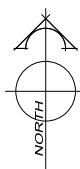


AMENDMENTS:		
AMENDMENT	DATE	DESCRIPTION
R1	16.7.12	SEWER PRESSUREMAIN ASBUILT ADDED.
R2	17.7.12	LATERALS FOR 3,4,5,6,7,22,35,43 & 46 EXTENDED.
R3	27.7.12	PUMPSTATION DETAIL & COORDINATES ADDED.


NOTES:

- 1) THIS PLAN HAS BEEN PREPARED FOR ASBUILT PURPOSES ONLY. NO LIABILITY IS ACCEPTED IF THE PLAN IS USED FOR ANY OTHER PURPOSE.
- 2) ANY MEASUREMENTS TAKEN FROM INFORMATION WHICH IS NOT DIMENSIONED ON THE ELECTRONIC COPY ARE AT THE RISK OF THE RECIPIENT.
- 3) ORIGIN OF LEVELS
BM.EHC6 RL=28.99
CORNER OF AWATEA & WIGRAM ROADS

LEVELS IN TERMS OF CHRISTCHURCH DRAINAGE DATUM.
JANUARY 2012 ISSUE

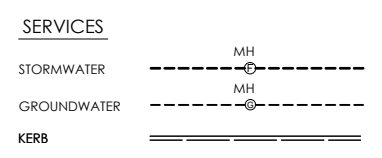

	NAME	SIGNED	DATE
DESIGNED BY	MATTHEW WENBORN		
CHECKED BY	ANDY HALL		

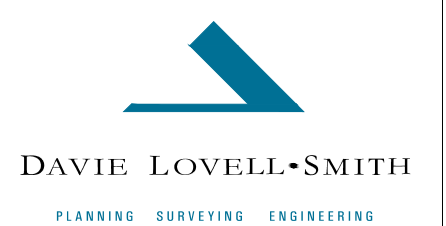

79 Cambridge Terrace P O Box 679 Christchurch 8140. New Zealand
Telephone: 03 379-0793 Fax: 03 379-5664 E-mail: office@dls.co.nz

JOB TITLE:
**Fulton Hogan Land Development Ltd
Longhurst Stages 1 & 1A**

SHEET TITLE:
**Stormwater - Asbuilt
RMA 92015254**

DRAWING STATUS:
Asbuilt

SCALE: 1:500@A1 DATE: July 2012
1:1000@A3

CAD FILE: J:\16011\Eng\Longhurst\Asbuilt\S16011.AB01 STG1 R3.dwg REVISION:
DRAWING No: SHEET No:
S.16011 ABSW03 R.3