





AMENDMENTS:		
AMENDMENT	DATE	DESCRIPTION

NOTES:

- 1) ALL LATERAL AND SEWER PRESSURE MAIN AS BUILT INFORMATION WAS PROVIDED BY FULTON HOGAN. LIMITED AND NO LIABILITY IS ACCEPTED FOR THE ACCURACY OF THIS INFORMATION.
- 2) THIS PLAN HAS BEEN PREPARED FOR ASBUILT PURPOSES ONLY. NO LIABILITY IS ACCEPTED IF THE PLAN IS USED FOR ANY OTHER PURPOSE.
- 3) ANY MEASUREMENTS TAKEN FROM INFORMATION WHICH IS NOT DIMENSIONED ON THE ELECTRONIC COPY ARE AT THE RISK OF THE RECIPIENT.
- 4) ORIGIN OF LEVELS
BM.EHC6 RL=28.99
CORNER OF AWATEA & WIGRAM ROADS

LEVELS IN TERMS OF CHRISTCHURCH DRAINAGE DATUM.
JANUARY 2012 ISSUE

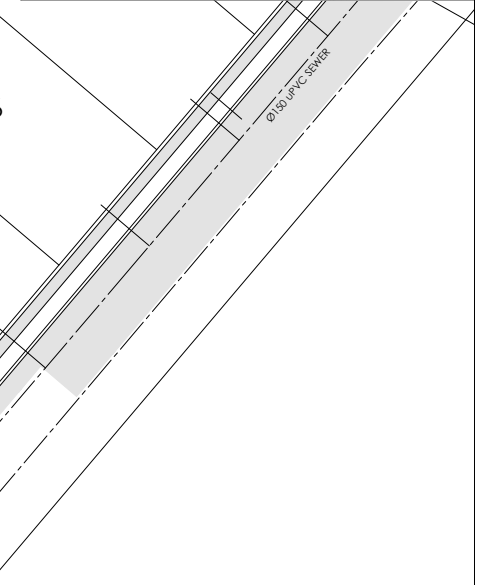


DAVIE LOVELL • SMITH
 PLANNING SURVEYING ENGINEERING

79 Cambridge Terrace P O Box 679 Christchurch 8140, New Zealand
 Telephone: 03 379-0793 Fax: 03 379-5664 E-mail: office@dls.co.nz

JOB TITLE:
Fulton Hogan Land Development Ltd Longhurst Stage 2

SHEET TITLE:
Sewer - Asbuilt RMA 92015254

DRAWING STATUS:
Asbuilt

SCALE: 1:500@A1
1:1000@A3

DATE: November 2012

CAD FILE: J:\16011\Eng\Longhurst\Asbuilt\S16011.AB01 STG2 R0.dwg

DRAWING No: S.16011

SHEET No: ABSS01

REVISION: R.0



AMENDMENTS:		
AMENDMENT	DATE	DESCRIPTION

NOTES:

- 1) ALL LATERAL AND SEWER PRESSURE MAIN AS BUILT INFORMATION WAS PROVIDED BY FULTON HOGAN LIMITED AND NO LIABILITY IS ACCEPTED FOR THE ACCURACY OF THIS INFORMATION.
- 2) THIS PLAN HAS BEEN PREPARED FOR ASBUILT PURPOSES ONLY. NO LIABILITY IS ACCEPTED IF THE PLAN IS USED FOR ANY OTHER PURPOSE.
- 3) ANY MEASUREMENTS TAKEN FROM INFORMATION WHICH IS NOT DIMENSIONED ON THE ELECTRONIC COPY ARE AT THE RISK OF THE RECIPIENT.
- 4) **ORIGIN OF LEVELS**
BM.EHC6 RL=28.99
CORNER OF AWATEA & WIGRAM ROADS

LEVELS IN TERMS OF CHRISTCHURCH DRAINAGE DATUM.
JANUARY 2012 ISSUE

SERVICES

SANITARY SEWER MH

SANITARY SEWER PRESSURE MAIN

EX SEWER MAIN

KERB

DESIGNED BY	NAME	SIGNED	DATE
	MATTHEW WENBORN		
CHECKED BY	ANDY HALL		

DAVIE LOVELL • SMITH
PLANNING SURVEYING ENGINEERING

79 Cambridge Terrace P O Box 679 Christchurch 8140. New Zealand
Telephone: 03 379-0793 Fax: 03 379-5664 E-mail: office@dls.co.nz

JOB TITLE:
Fulton Hogan Land Development Ltd
Longhurst Stage 2

SHEET TITLE:
Sewer - Asbuilt
RMA 92015254

DRAWING STATUS:
Asbuilt

SCALE: 1:500@A1 DATE: November 2012
1:1000@A3

CAD FILE: J:\16011\Eng\Longhurst\Asbuilt\S16011.AB01 STG2 R0.dwg REVISION:

DRAWING No: **S.16011** SHEET No: **ABSS02** **R.0**