


AMENDMENTS:		
AMENDMENT	DATE	DESCRIPTION

- NOTES:
- 1) This plan has been prepared for sewer asbuilt purposes only. No liability is accepted if the plan is used for any other purpose.
  - 2) Any measurements taken from information which is not dimensioned on the electronic copy are at the risk of the recipient.
  - 3) All roading and foot path information is asbuilt.
  - 4) All sewer laterals are Ø100mm uPVC unless otherwise specified.
  - 5) All lateral positions as-built as marked by C&A Cox and have not been verified.

Origin of Levels  
 SS11A SO 797  
 Brass Plaque  
 RL=9.42m

All Levels are in terms of Lyttelton Vertical Datum 1937.  
 Levels are Pre 2010 & 2011 Canterbury Earthquakes.

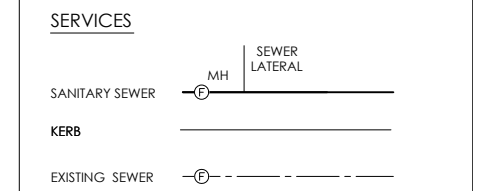

116 Wrights Road P O Box 679 Christchurch 8140, New Zealand  
 Telephone: 03 379-0793 Website: www.dls.co.nz E-mail: office@dls.co.nz

JOB TITLE:  
**Fulton Hogan Ltd.  
 Rosemerryn - Lincoln Stage 10**

SHEET TITLE:  
**Sewer - Asbuilt**

DRAWING STATUS:  
**Stage 10 Asbuilt**

SCALE: 1:500@A1 DATE: July 2016  
 1:1000@A3


CAD FILE: J:\18723\AS Bui\18723\_AB\_NZTM.dwg REVISION:  
 DRAWING No: SHEET No:  
**E18723.AB01.SS01** **RO**



Lot 2000  
 D.P.493354


**STAGE 10**



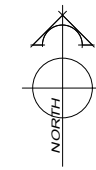

AMENDMENTS:		
AMENDMENT	DATE	DESCRIPTION

- NOTES:
- 1) This plan has been prepared for water asbuilt purposes only. No liability is accepted if the plan is used for any other purpose.
  - 2) Any measurements taken from information which is not dimensioned on the electronic copy are at the risk of the recipient.
  - 3) All roading and foot path information is asbuilt.
  - 4) All submains are Ø63mm PE Blueline PN12.5 with associated fittings.
  - 5) All mains are uPVC PN12 or similar approved.
  - 6) All water laterals are Ø25mm PE Blueline PN12.5 with associated fittings.

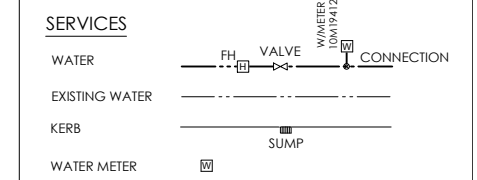

**DAVIE LOVELL-SMITH**  
PLANNING SURVEYING ENGINEERING

116 Wrights Road P O Box 679 Christchurch 8140, New Zealand  
Telephone: 03 379-0793 Website: www.dls.co.nz E-mail: office@dls.co.nz

JOB TITLE:  
**Fulton Hogan Ltd.  
Rosemerryn - Lincoln Stage 10**

SHEET TITLE:  
**Water - Asbuilt**

DRAWING STATUS:  
**Stage 10 Asbuilt**

SCALE: 1:500@A1 DATE: July 2016  
1:1000@A3

CAD FILE: J:\18723\As Built\E18723\_AB\_NZTM.dwg REVISION:  
DRAWING No: SHEET No:  
**E18723.AB01.W01** **RO**