



AMENDMENTS:		
AMENDMENT	DATE	DESCRIPTION

NOTES:

NOTES:

- 1) THIS PLAN HAS BEEN PREPARED FOR EARTH FILL ASBUILT PURPOSES ONLY. NO LIABILITY IS ACCEPTED IF THE PLAN IS USED FOR ANY OTHER PURPOSE.
- 2) ANY MEASUREMENTS TAKEN FROM INFORMATION WHICH IS NOT DIMENSIONED ON THE ELECTRONIC COPY ARE AT THE RISK OF THE RECIPIENT.
- 3) ORIGIN OF LEVELS:
SS 11A SO 797, PLAQUE ON CONCRETE BLOCK RL=9.42 LEVELS IN TERMS OF LYTLETON VERTICAL DATUM 1937. PRE EARTHQUAKE.

CONTOURS SHOWN ARE APPROXIMATELY CUT (-ve) AND FILL (+ve) AT 0.2m INTERVALS.

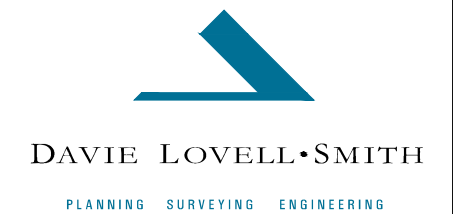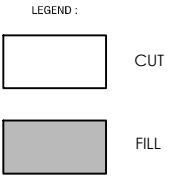

79 Cambridge Terrace P O Box 679 Christchurch 8140, New Zealand
Telephone: 03 379-0793 Fax: 03 379-5664 E-mail: office@dls.co.nz

JOB TITLE: **Fulton Hogan Ltd.
Rosemeryn - Lincoln
Stage 4
Subdivision Ref: 115172**

SHEET TITLE: **Earthworks
Earth Fill Report**


DRAWING STATUS: **Asbuilt**

SCALE: 1:500@A1 DATE: March 2014
1:1000@A3


CAD FILE: J:\18239\ASBUILT\18239.AB.EW.SDC.dwg REVISION:
DRAWING No: E18239.AB. SHEET No: 1 of 1
E02.1 RO



AMENDMENTS:		
AMENDMENT	DATE	DESCRIPTION

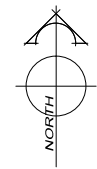

SERVICES:

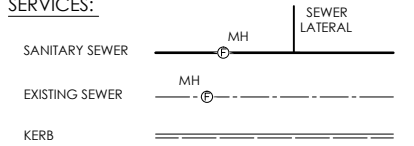

NOTES:

1. LOCATION OF LATERALS PROVIDED BY FULTON HOGAN LIMITED.
 2. ALL LATERALS ARE LAYED AT 1:60 MINIMUM GRADE.
 3. ALL LATERALS ARE Ø100mm uPVC.
 4. LEVELS IN TERMS OF MEAN SEA LEVEL LYTELTON DATUM 1937.
- ORIGIN OF LEVELS :SS1 1A SO 797 RL=9.42.



DAVIE LOVELL·SMITH
 PLANNING SURVEYING ENGINEERING

79 Cambridge Terrace P O Box 679 Christchurch 8140, New Zealand
 Telephone: 03 379-0793 Fax: 03 379-5664 E-mail: office@dls.co.nz


JOB TITLE:
**Fulton Hogan Ltd.
 Rosemerryn - Lincoln
 Stage 4**

SHEET TITLE:
Sewer Asbuilt

DRAWING STATUS:
Asbuilt

SCALE: 1:500@A1 DATE: March 2014
 1:1000@A3

CAD FILE: J:\18239\ASBUILT\18239-AB01.SDC.dwg REVISION:
 DRAWING No: SHEET No:
E18239.AB.SS01.0 RO

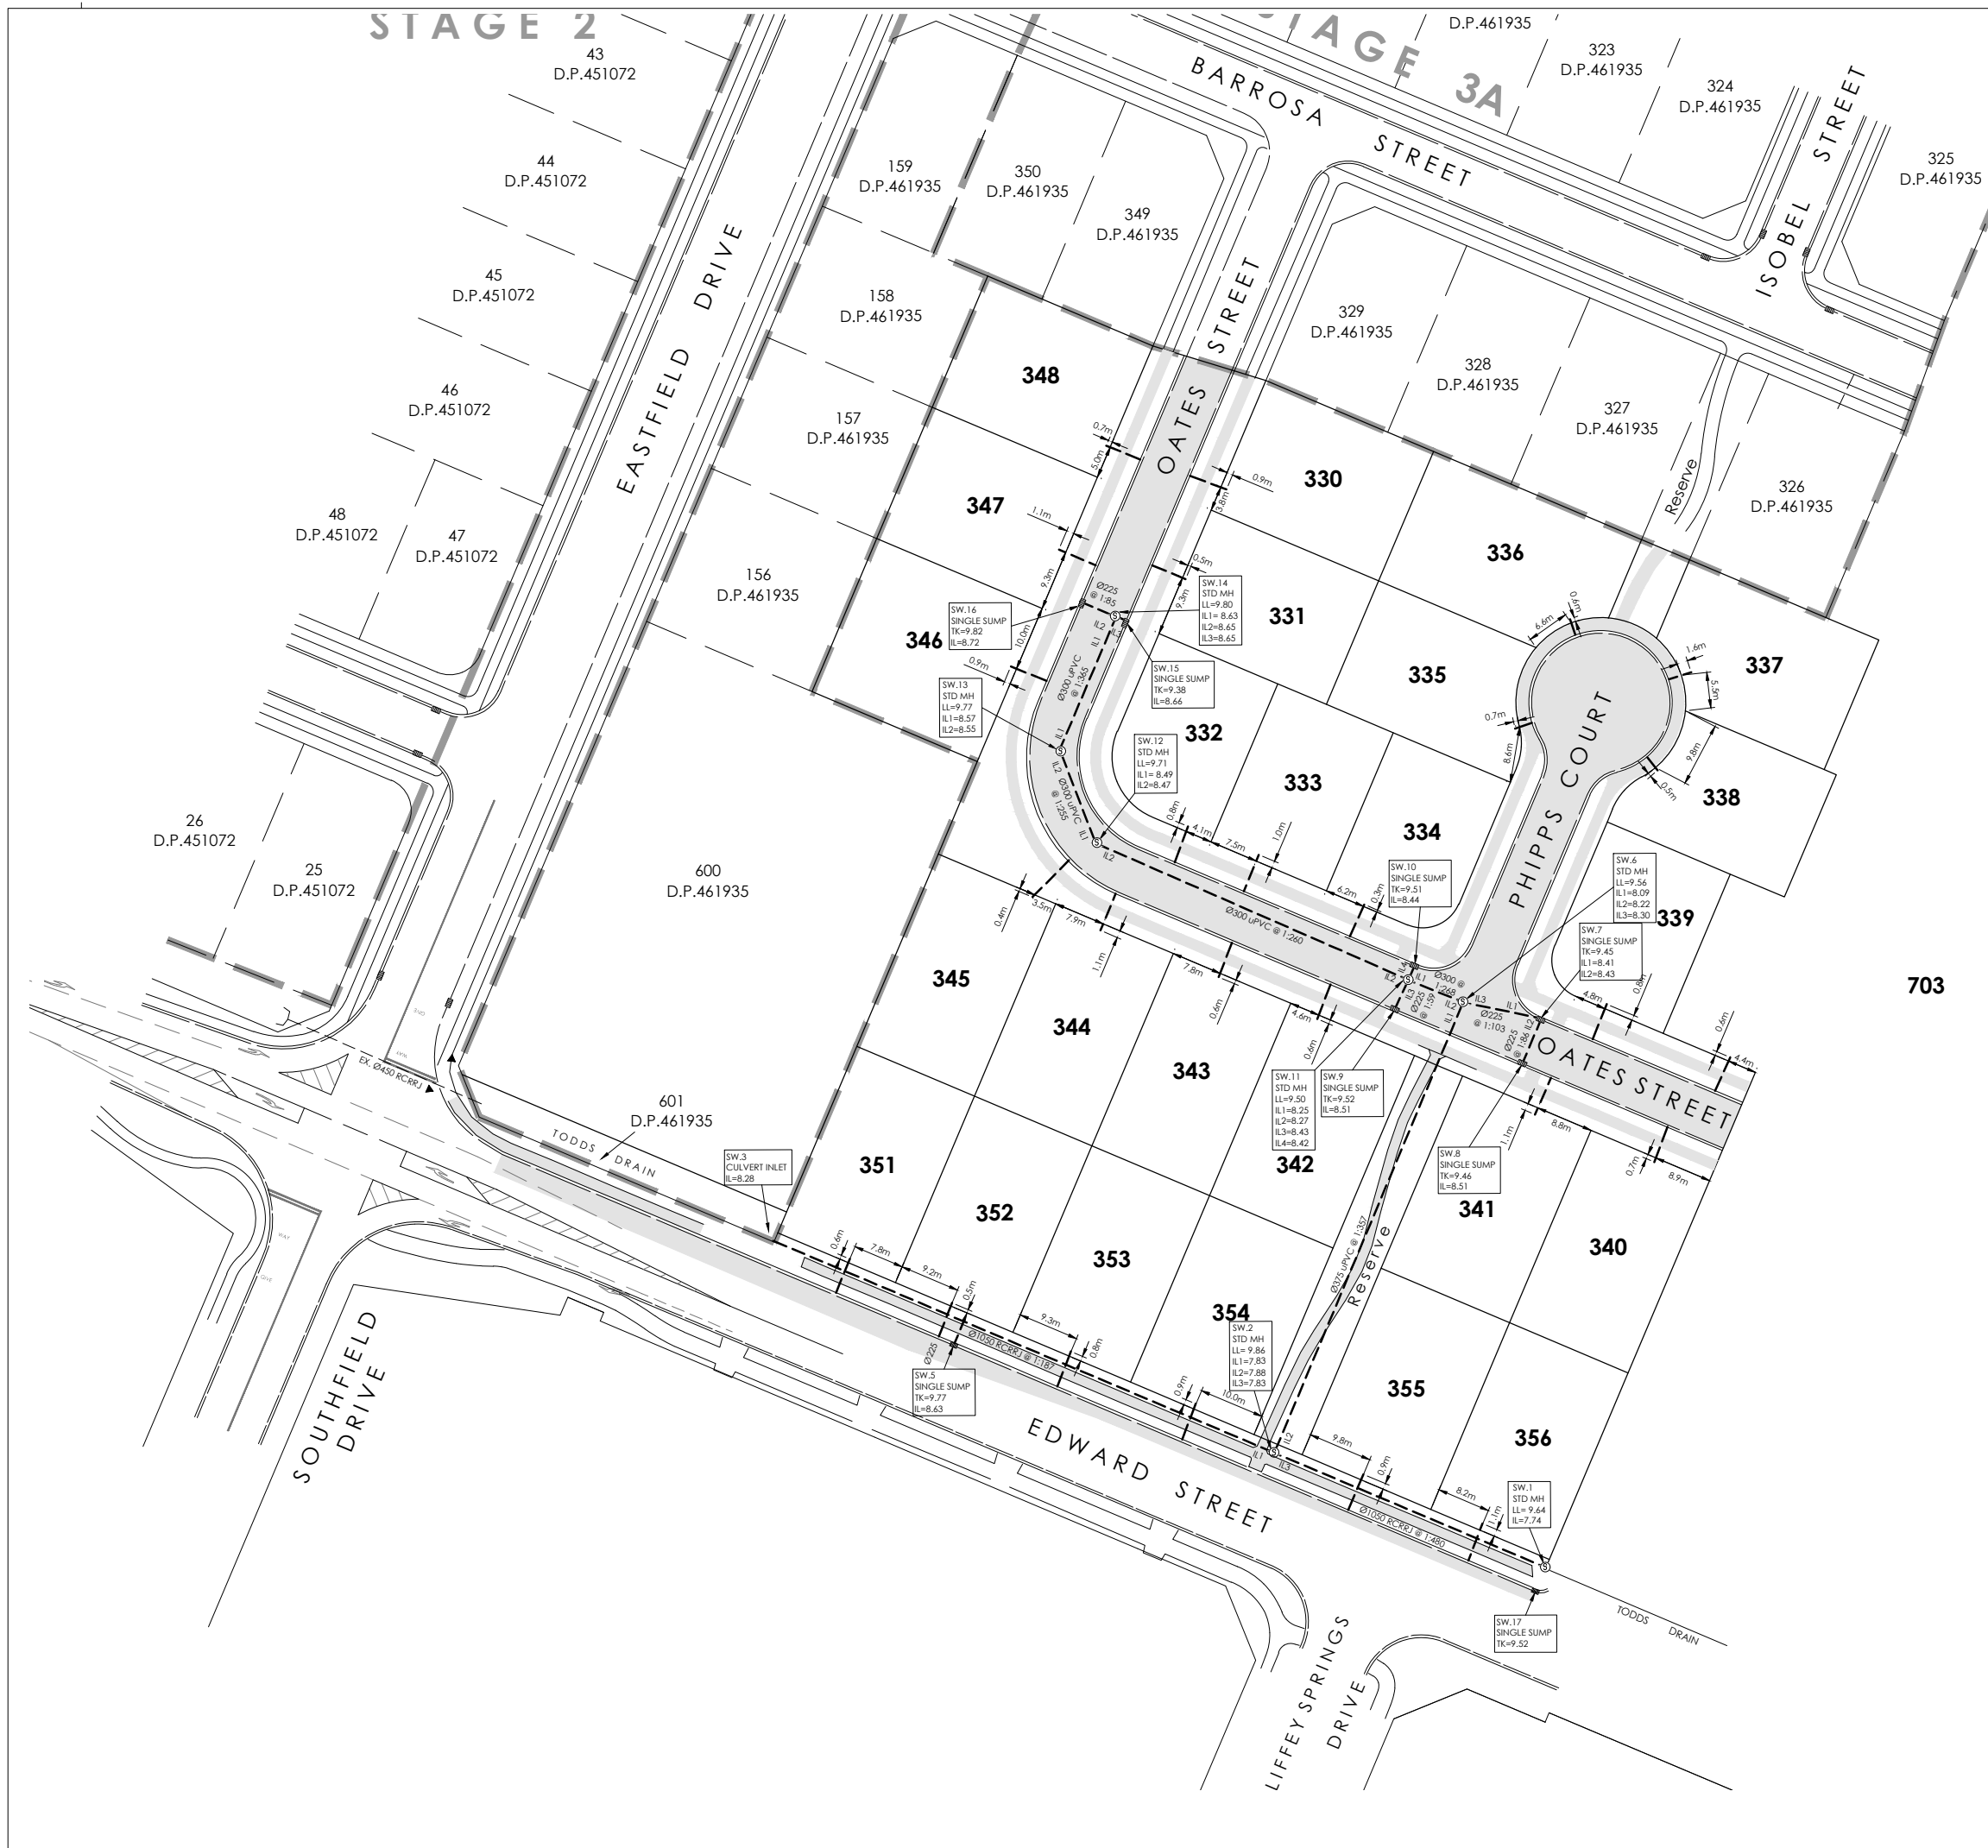

AMENDMENTS:		
AMENDMENT	DATE	DESCRIPTION

NOTES:

SERVICES:

STORMWATER ———— MH ————

EXISTING STORMWATER ———— MH ————

KERB ————

- NOTES:
1. LOCATION OF LATERALS PROVIDED BY FULTON HOGAN LIMITED.
 2. ALL CONNECTIONS TO KERB ADAPTORS ARE EVIDENT ON SITE.
 3. ALL STORMWATER LATERALS ARE Ø100mm uPVC UNLESS SHOWN OTHERWISE.
 4. LEVELS IN TERMS OF MEAN SEA LEVEL LYTTELTON DATUM 1937.
- ORIGIN OF LEVELS :SS1 1A SO 797 RL=9.42.

DAVIE LOVELL·SMITH

PLANNING SURVEYING ENGINEERING

79 Cambridge Terrace P O Box 679 Christchurch 8140, New Zealand
 Telephone: 03 379-0793 Fax: 03 379-5664 E-mail: office@dls.co.nz


JOB TITLE:
**Fulton Hogan Ltd.
 Rosemerryn - Lincoln
 Stage 4**

SHEET TITLE:
Stormwater Asbuilt

DRAWING STATUS:
Asbuilt


SCALE: 1:500@A1 DATE: March 2014
 1:1000@A3

CAD FILE: J:\18239\ASBUILT\18239.AB01.SDC.dwg REVISION:
 DRAWING No: SHEET No:
E18239.AB.SW01.0 RO

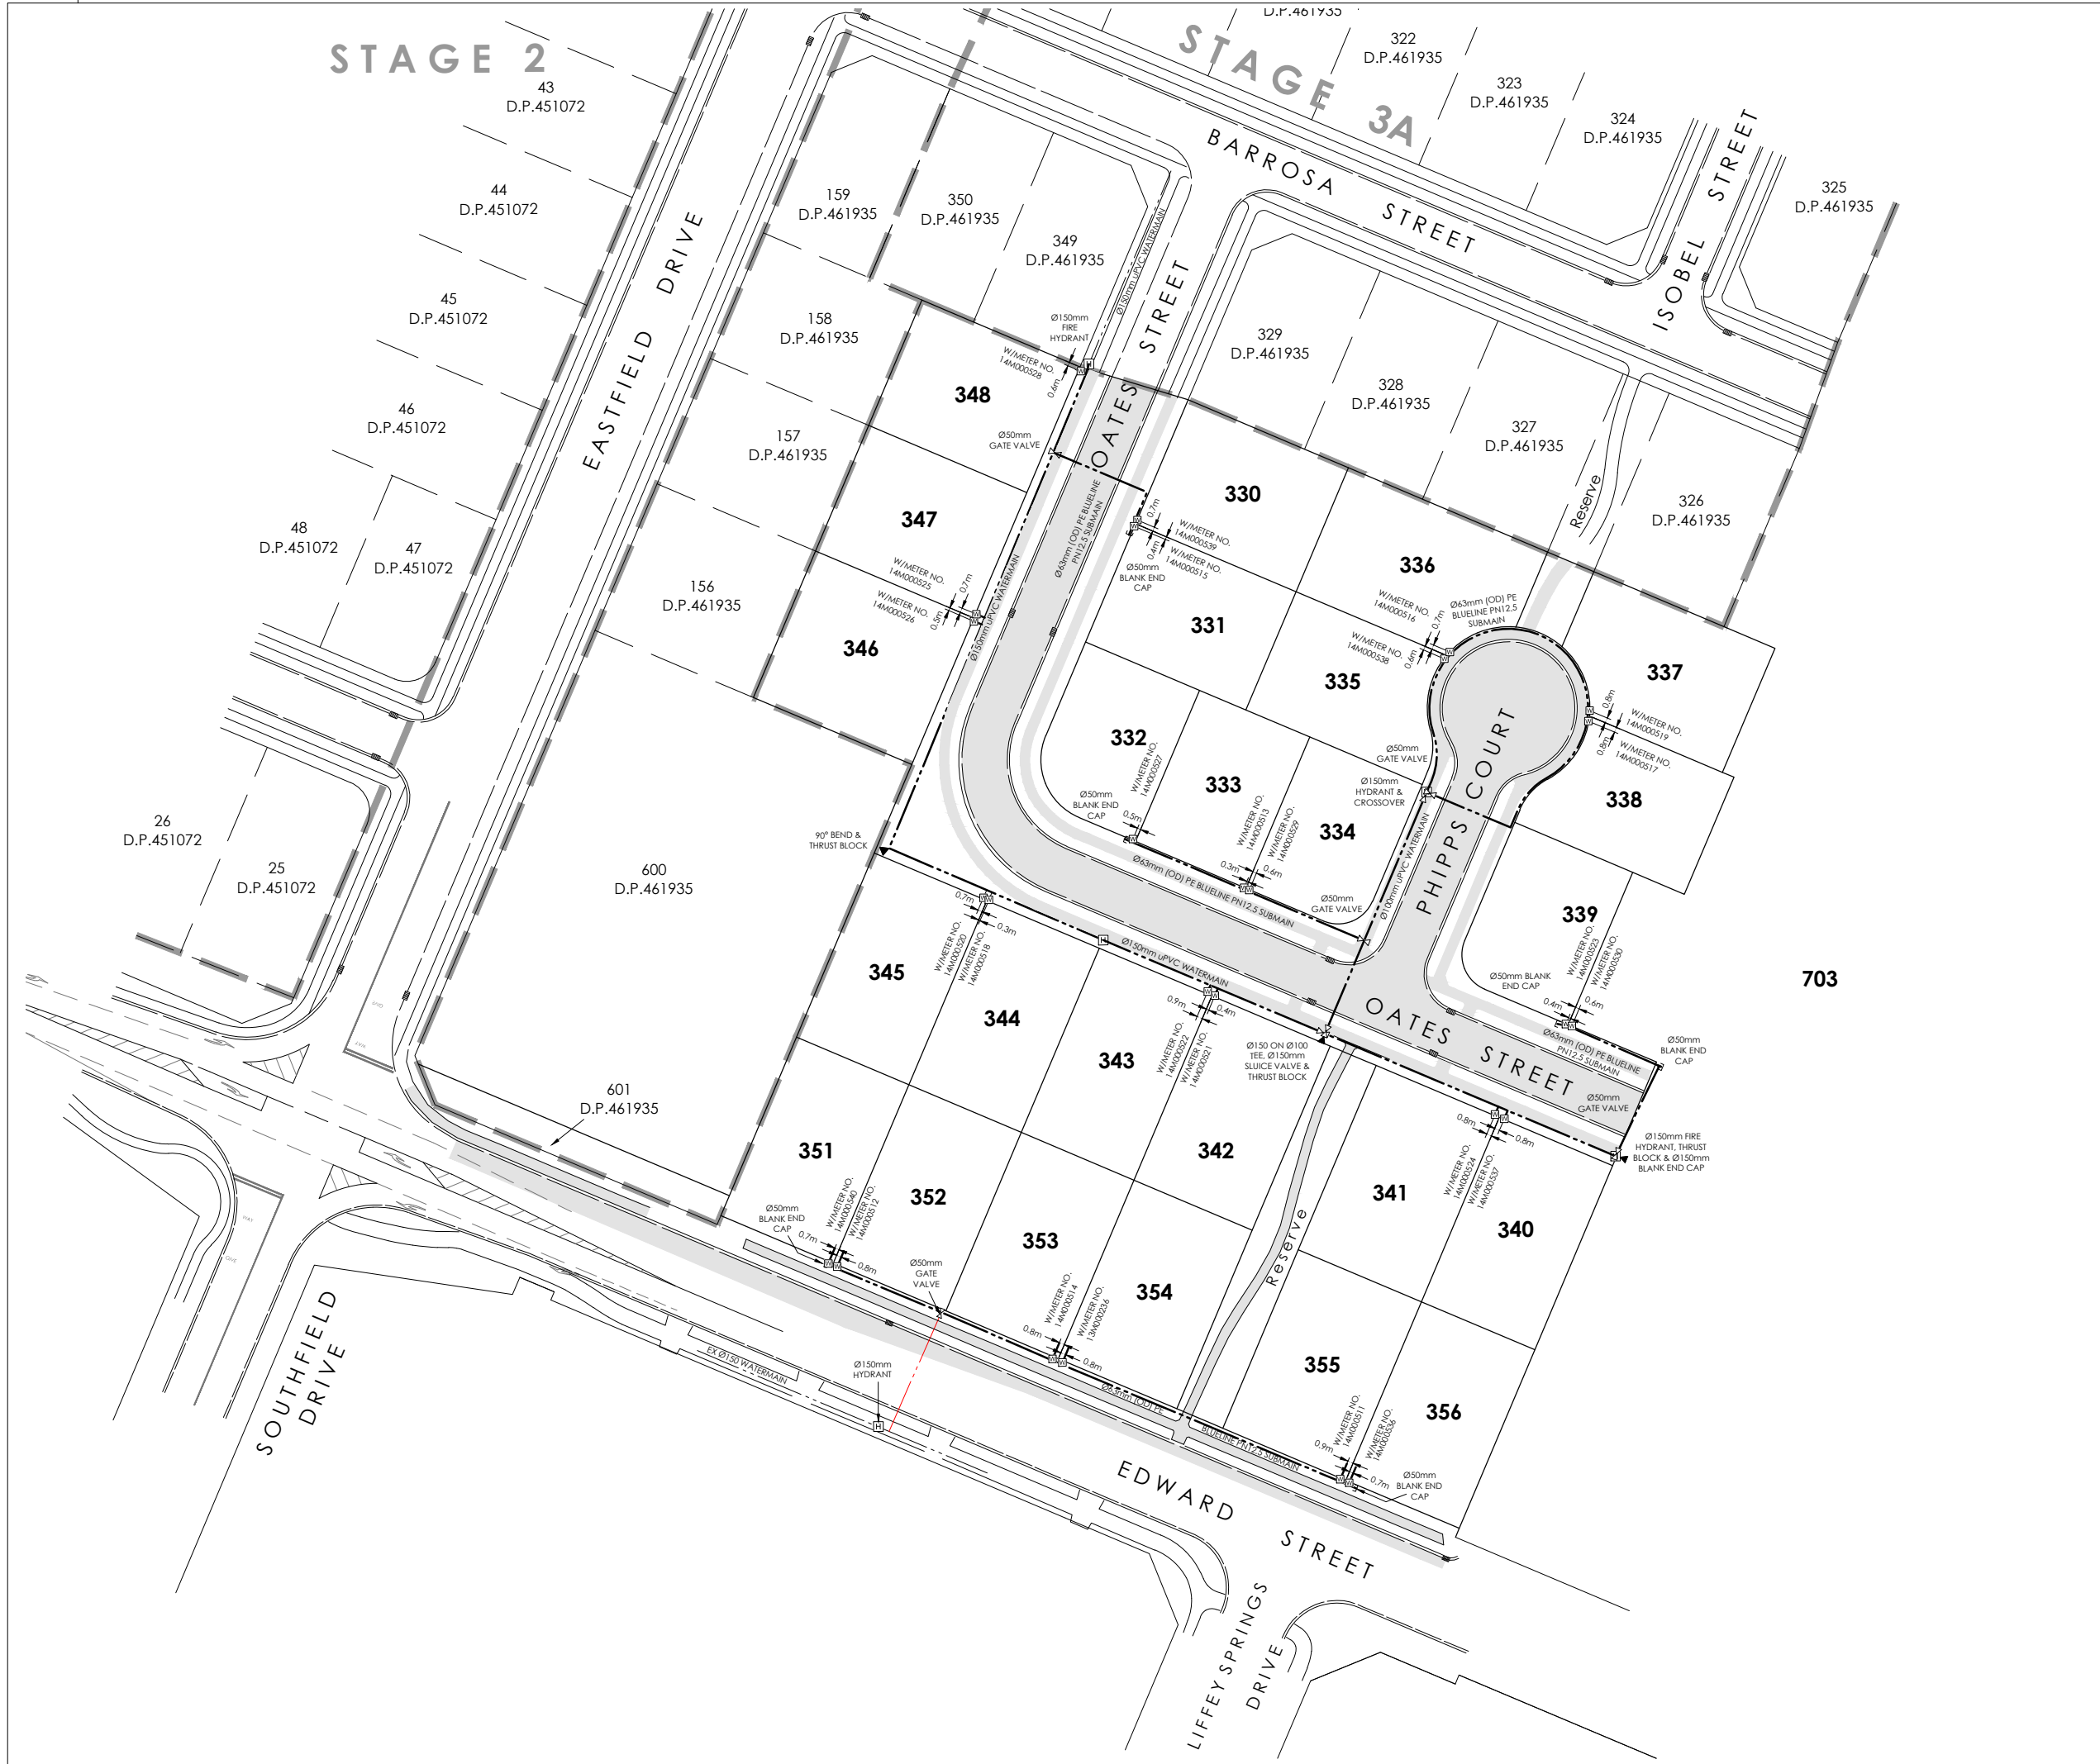


AMENDMENTS:		
AMENDMENT	DATE	DESCRIPTION

NOTES:

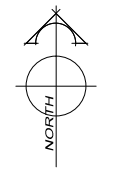

SERVICES:

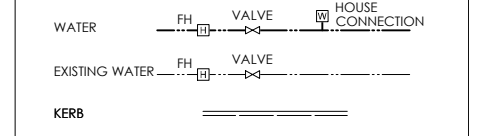

NOTES:

1. ALL SUBMAINS ARE Ø63mm (OD) PE BLUELINE PN12.5 WITH ASSOCIATED FITTINGS.
2. ALL HOUSE CONNECTIONS ARE 25mm POLY AND INCLUDE GATE VALVE, TOBY BOX, TAPPING BAND & FERRALE.
3. ALL MAINS ARE CLASS D uPVC OR SIMILAR APPROVED.
4. ALL WATER LATERALS ARE Ø25mm PE 'BLUELINE' PN12.5 WITH ASSOCIATED FITTINGS.

DAVIE LOVELL-SMITH
 PLANNING SURVEYING ENGINEERING

79 Cambridge Terrace P O Box 679 Christchurch 8140, New Zealand
 Telephone: 03 379-0793 Fax: 03 379-5664 E-mail: office@dls.co.nz

JOB TITLE:
**Fulton Hogan Ltd.
 Rosemerryn - Lincoln
 Stage 4**

SHEET TITLE:
Water Asbuilt

DRAWING STATUS:
Asbuilt

SCALE: 1:500@A1 DATE: March 2014
 1:1000@A3

CAD FILE: J:\18239\ASBUILT\18239-AB01-SDC.dwg REVISION:
 DRAWING No: SHEET No: 1 of 1
E18239.AB.W01.0 **RO**